


CALCULATION SUMMARY		AREA NAME		DIMENSIONS		GRID NAME		AVE	MAX	MIN	MAX/MIN AVE/MIN
		MARKET		10'x10'		2.6		14.6	0.6	20.0	4.0
LUMINAIRE SCHEDULE											
TYP	SYMB.	DESCRIPTION	LAMP	LUMENS	MOUNTING	LLF	QTY				
BLDG		WPLED26-BUILDING MOUNTED LIGHT	30W	3,666	15' BUILDING MOUNT	1.00	4				
AREA		ALED4T78Y-AREA LIGHT	77W	10,504	20' POLE MOUNT	1.00	10				
*NOTE: LIGHTING VALUES SHOWN IN RED HAVE BEEN USED TO CALCULATE THE UNIFORMITY RATIO, WHILE LIGHTING VALUE SHOWN IN BLACK HAVE BEEN SHOWN TO SHOW OVERALL COVERAGE.											

OWNER/APPLICANT

Noyes Properties, LLC
PO Box 42
Richmond, VT 05477

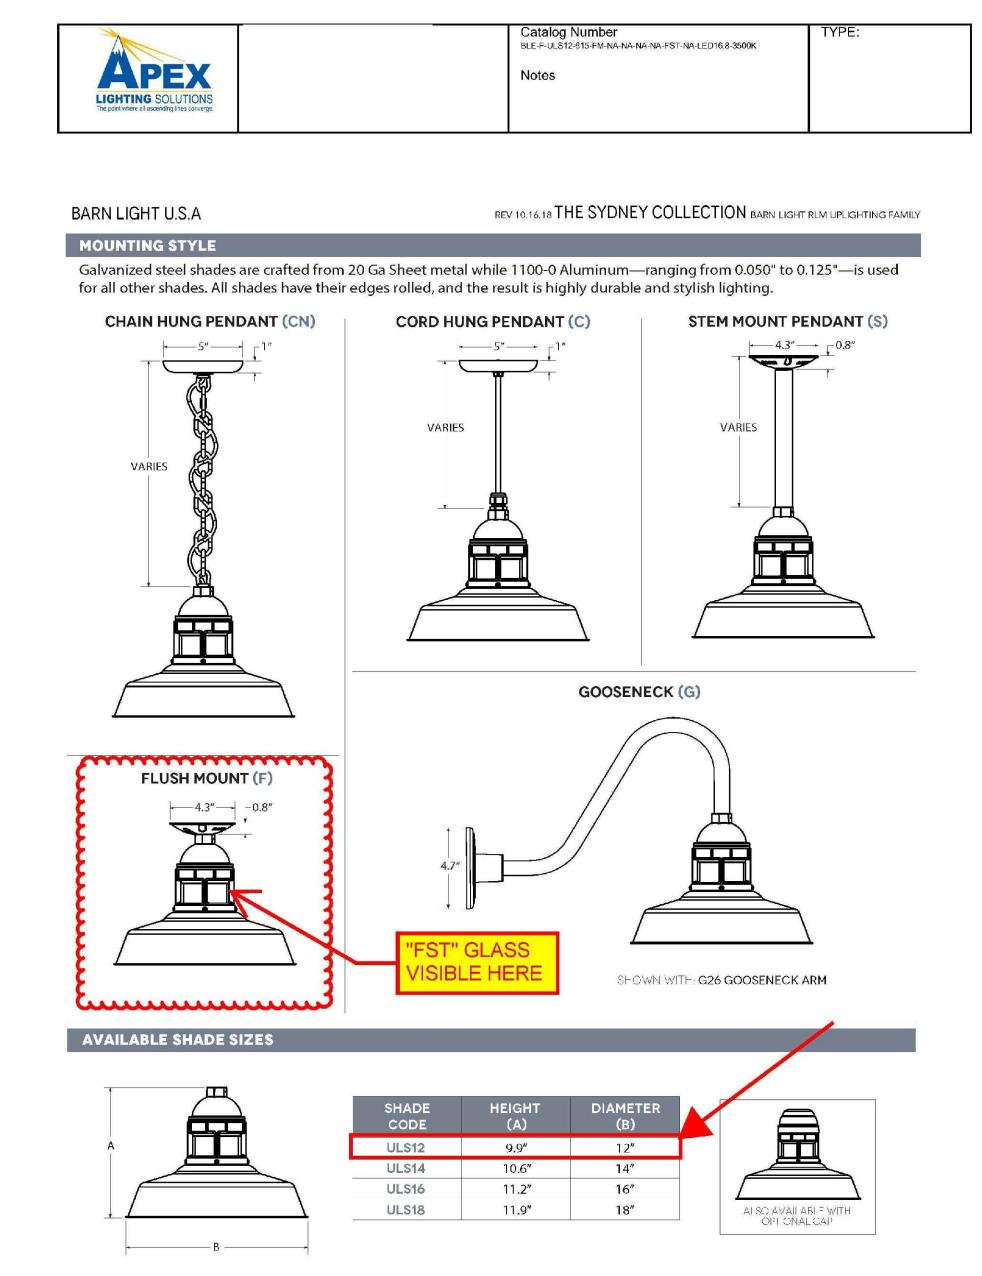


OVERHANG MOUNTED FIXTURE
NTS

BUILDING MOUNTED FIXTURE
NTS




BUILDING MOUNTED FIXTURE
NTS


Address: 200 Main Street, Suite 100, Tewksbury, MA 01876 | Phone: (978) 944-0204 | Email: sales@olearyburke.com | Website: www.olearyburke.com
Copyright © 2020 OLEARY-BURKE. All Rights Reserved. Note: Specifications are subject to change at any time without notice.
Page 1 of 2

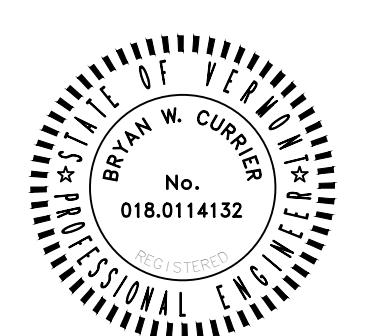

9-16-21
DATE 8-30-21
REVISION ADDED LIGHTING SPECIFICATION FOR UNDERNEATH 5' OVERHANG ON SOUTH AND WEST SIDES OF BUILDING
BY BWC
SURVEY OBCA
 RECORD DRAWING PRELIMINARY
 FINAL SKETCH/CONCEPT
DESIGN BWC
DRAWN BWC
CHECKED PJO
SCALE 1'=30'
BWC
DATE 3-18-21
OLEARY-BURKE CIVIL ASSOCIATES, PLC
13 CORPORATE DRIVE, ESSEX JCT, VT
PHONE: (802) 865-9999
FAX: (878) 9999
E-MAIL: obc@olearyburke.com
Richmond, Vermont
FILE # S13
PLAN SHEET # 4
Lighting Plan

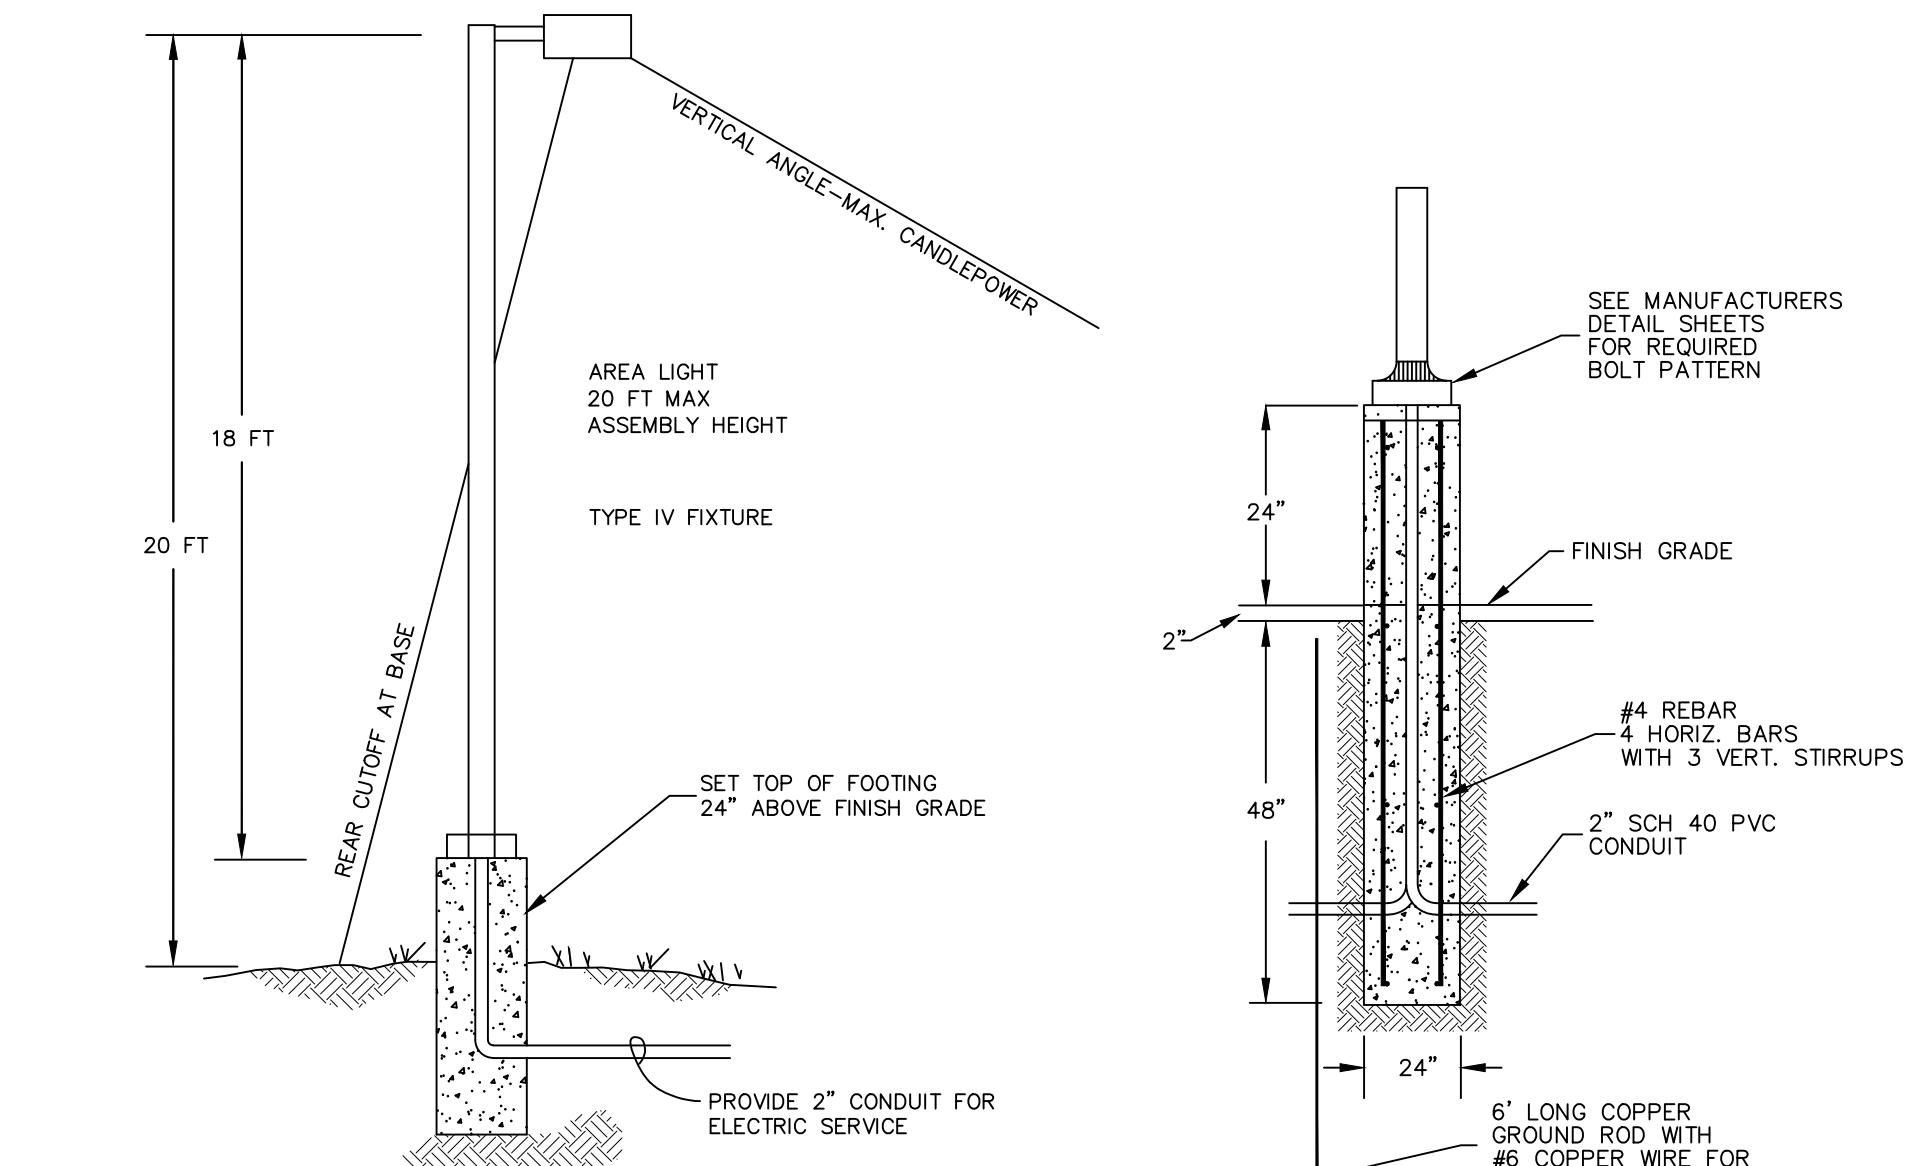

TYPICAL LIGHT POLE DETAIL
NTS

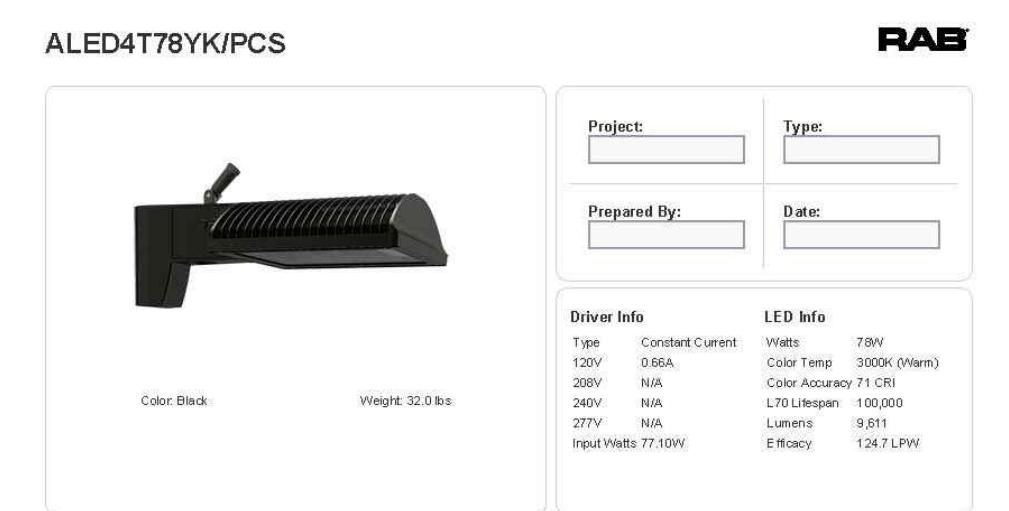


Project: _____ Type: _____
Prepared By: _____ Date: _____

Driver Info: Type: Constant Current, 0.65A, 200V N/A, 240V N/A, 277V N/A, Input Watts: 77.15W
LED Info: Watts: 78W, Color Temp: 3000K (Warm), Color Accuracy: 71 CRI, Lumen: 8,911, Efficacy: 124.1 LPW
Color Block
Weight: 32.0 lbs

Technical Specifications
Listings: UL Listed, Suitable for wet locations. Suitable for mounting within 1' (2m) of the ground.
UL Driver: Constant Current, Class 2, 2000mA, 100-277V, 0.65A, Power Factor: 99%
THD: 5.0% @ 120V, 13% @ 277V
Power Factor: 99.6% @ 120V, 99.6% @ 277V
Surge Protection: 4kV

RAB
ALED4T78YK-PCS

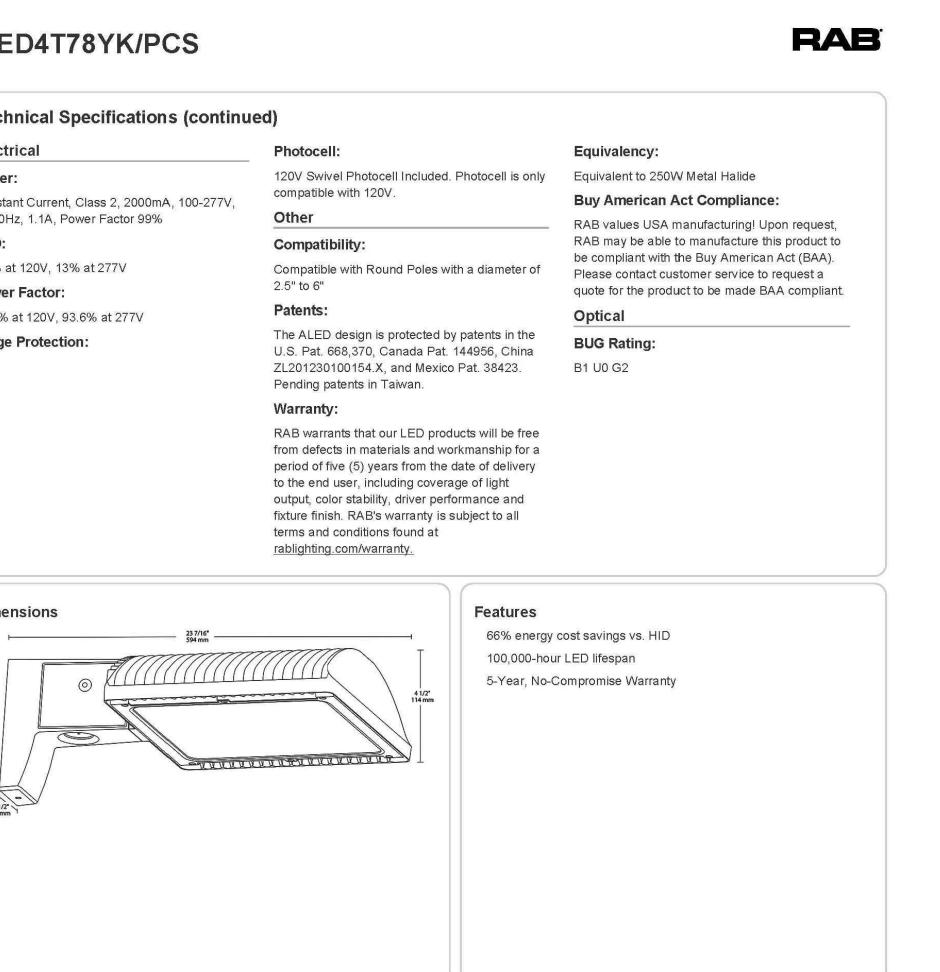


Project: _____ Type: _____
Prepared By: _____ Date: _____

Driver Info: Type: Constant Current, 0.65A, 200V N/A, 240V N/A, 277V N/A, Input Watts: 77.15W
LED Info: Watts: 78W, Color Temp: 3000K (Warm), Color Accuracy: 71 CRI, Lumen: 8,911, Efficacy: 124.1 LPW
Color Black
Weight: 32.0 lbs

Technical Specifications (continued)
Listings: UL Listed, Suitable for wet locations as a downlight.
UL Driver: Constant Current, Class 2, 2000mA, 100-277V, 0.65A, Power Factor: 99%
THD: 5.0% @ 120V, 13% @ 277V
Power Factor: 99.6% @ 120V, 99.6% @ 277V
Surge Protection: 4kV

RAB
ALED4T78YK-PCS

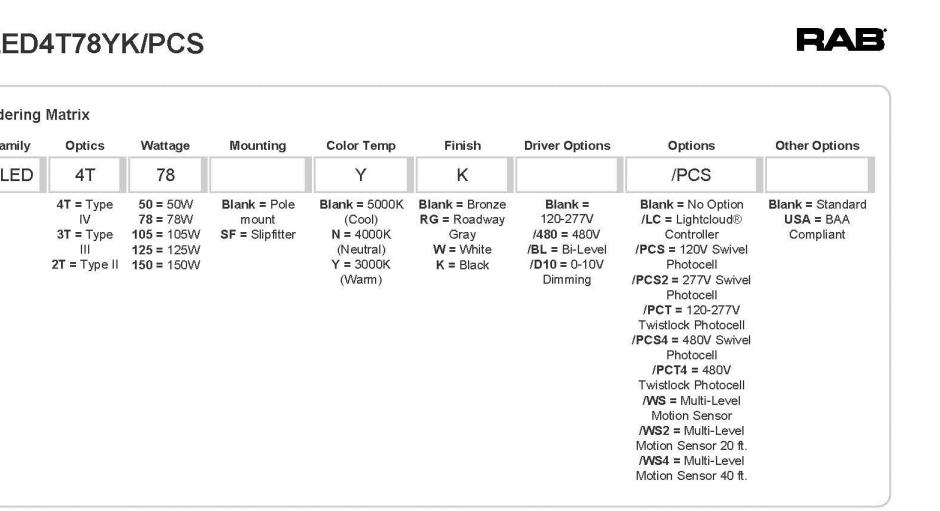

Project: _____ Type: _____
Prepared By: _____ Date: _____

Driver Info: Type: Constant Current, 0.65A, 200V N/A, 240V N/A, 277V N/A, Input Watts: 77.15W
LED Info: Watts: 78W, Color Temp: 3000K (Warm), Color Accuracy: 71 CRI, Lumen: 8,911, Efficacy: 124.1 LPW
Color Black
Weight: 32.0 lbs

Technical Specifications (continued)
Listings: UL Listed, Suitable for wet locations as a downlight.
UL Driver: Constant Current, Class 2, 2000mA, 100-277V, 0.65A, Power Factor: 99%
THD: 5.0% @ 120V, 13% @ 277V
Power Factor: 99.6% @ 120V, 99.6% @ 277V
Surge Protection: 4kV


RAB
ALED4T78YK-PCS

Need help? Tech help line: (888) 722-1000 Email: customer@rabbilighting.com Website: www.rabbilighting.com
Copyright © 2020 RAB Lighting All Rights Reserved. Note: Specifications are subject to change at any time without notice.
Page 1 of 3

Need help? Tech help line: (888) 722-1000 Email: customer@rabbilighting.com Website: www.rabbilighting.com
Copyright © 2020 RAB Lighting All Rights Reserved. Note: Specifications are subject to change at any time without notice.
Page 2 of 3

Need help? Tech help line: (888) 722-1000 Email: customer@rabbilighting.com Website: www.rabbilighting.com
Copyright © 2020 RAB Lighting All Rights Reserved. Note: Specifications are subject to change at any time without notice.
Page 3 of 3

POLE MOUNTED FIXTURE
NTS

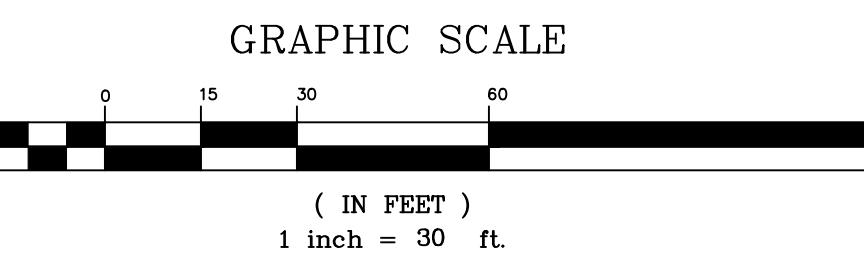

GRAPHIC SCALE

(IN FEET)
1 inch = 30 ft.