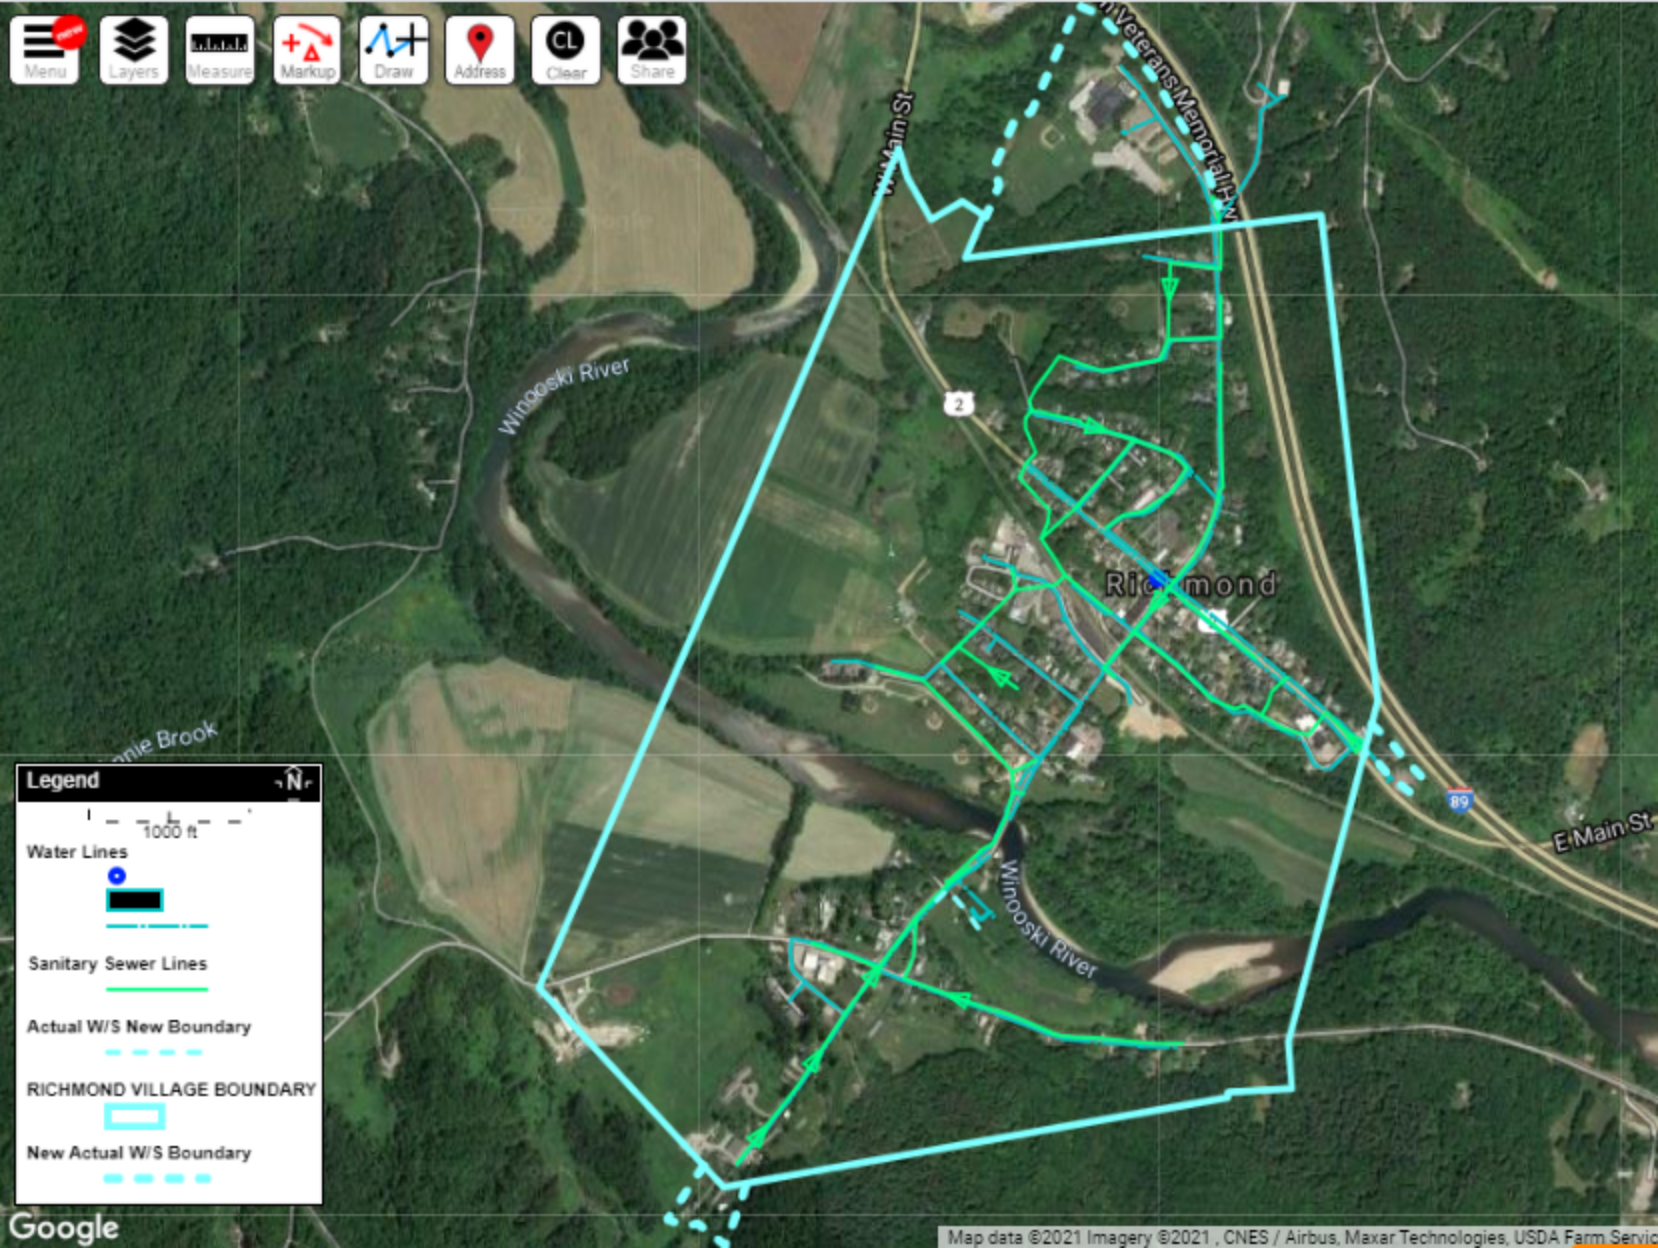
Menu
Layers
Measure
Markup
Draw
Address
Clear
Share
Veterans Memorial Pkwy
W Main St
Winooski River
2
Richmond
89
E Main St
Winooski River
Legend
N
1000 ft
Water Lines
Sanitary Sewer Lines
Actual W/S New Boundary
RICHMOND VILLAGE BOUNDARY
New Actual W/S Boundary
Google
Map data ©2021 Imagery ©2021 , CNES / Airbus, Maxar Technologies, USDA Farm Servic